

ANSONIA PARK AND RIVERWALK, SEGMENTS 3 & 4
CITY OF ANSONIA, CONNECTICUT
Conn D.O.T. PROJECT NO. 002-128
FEDERAL AID PROJECT NO. CN: PEDS (214)

ADDENDUM NO. 2

NOVEMBER 23, 2020

DESCRIPTION OF ADDENDUM

Addendum No. 2 extends the bid opening date pending the receipt of the approved Connecticut Department of Energy and Environmental Protection – DAM Safety Permit. The addendum includes the bidder questions with responses.

The following information is hereby made part of the contract documents:

REVISED SPECIFICATIONS

The responses to questions serve as supplement to the Special Provisions. The following Special Provision is hereby replaced with the like-numbered Special Provision:

- Item #0992132A – ORNAMENTAL MEDALLIONS

REVISED CONTRACT ITEMS

There are no changes to the contract items.

PLANS

The following Plan Sheets are hereby replaced with the like-numbered Plan Sheets:

- Sheet No. 03.10.A2 – SITE DETAILS
- Sheet No. 03.11.A2 – SITE DETAILS

OTHER INFORMATION

Bid Opening

Sealed bids will be received by the Office of the Town & City Clerk, 253 Main Street, Ansonia, CT 06401, until 10:00 A.M. local time, on December 9, 2020. Bids will then be publicly opened and read aloud.

QUESTIONS FROM CONTRACTOR AND CORRESPONDING ANSWERS:

E-mail from Waters Construction Co. – November 2nd, 2020

Question 1: Please provide a manufacturer of the rest structure so we can ensure the pricing of exactly what Ansonia expects prior to bidding.

Response: **The rest structures are non-proprietary, the Contractor shall provide, for the City's representative approval, a product that conforms to the special provision for Item #0992091A – Rest Shelter and the contract details.**

Question 2: Please provide a plan detail for the ornamental medallions as this is not in the plans and specifications.

Response: **Ornamental medallions shall conform to the special provision for Item #0992132A – Ornamental Medallion. The circular plaque shall be 30" in diameter and have the City of Ansonia seal, see attached details. The rectangular plaque shall be 36" by 36", see attached detail for the text. Both plaques shall be shallow (1/8") Bas-relief.**

E-mail from Empire Paving Inc. – November 11th, 2020

Question 3: Can we get the name of manufacturers of the Rest Shelter super structural components?

Response: **The rest structures are non-proprietary, the Contractor shall provide, for the City's representative approval, a product that conforms to the special provision for Item #0992091A – Rest Shelter and the contract details**

E-mail from Mather Corporation – November 12th, 2020

Question 4: Can you please provide the manufacturer of the rest shelter details used in the plans?

Response: **See response to Question 1.**

Question 5: We need clarification on item #0906203A Split Rail Fence; Special Provision Specification calls out Cedar Rails and Pressure Treated Posts and drawing No L-3 details cedar posts and rails. Please clarify if they want the fence in all pressure treated or all cedar.

Response: **The Split Rail fence shall have Cedar Rails and Southern Yellow Pine posts with a 0.40 lbs/cf pressure treating for ground contact.**

Question 6: Is the testing laboratory for soil compaction and concrete inspection by the owner or the contractor?

Response: **Soil compaction and concrete testing will be the responsibility of the Owner.**

Question 7: Please confirm the compass rose is a concrete stamp? Please confirm, coloring or staining is not required of the concrete if it is a stamp?

Response: **The compass rose shall be stamped concrete and shall be stained in an antiqued style.**

Question 8: Please provide size and installation details of the flush Bronze plaque and historical town seal?

Response: **See response to Question 2.**

**INVITATION TO BID
CONSTRUCTION OF ANSONIA
RIVERWALK - SEGMENTS 3 & 4
STATE PROJECT NO. 002-128
FEDERAL PROJECT CN: PEDS(214)
CITY OF ANSONIA**

The City of Ansonia, Connecticut is soliciting sealed bids for furnishing all labor, tools, materials and equipment required for the proposed Segments 3 and 4 of the Riverwalk project consisting of a paved walkway on the existing levee embankment that will extend from Division Street to the Target property on the East side of the Naugatuck River. The Riverwalk crest will have a 10-foot wide bituminous concrete surface with a wood and post rail fence on each side to match the existing Riverwalk.

Sealed bids will be received by the Office of the Town & City Clerk, 253 Main Street, Ansonia, CT 06401, until 10:00 A.M. local time, on December 9, 2020. Bids will then be publicly opened and read aloud. No Bidder may withdraw their bid for a period of 120 days after the date of bid opening.

A non-mandatory pre-bid meeting will be held at 1:00 P.M. on October 29, 2020 at the following Zoom link:

<https://us04web.zoom.us/j/72266027861?pwd=YXM3VnlOcnpqdlhNVkVNM1AzY0lMZz09>

Passcode: 1L95Ht

The Contract Documents are available for review only at Ansonia City Hall, City & Town Clerks Office which is open Monday, Tuesday and Wednesday 8:30 A.M. to 4:30 P.M. and Thursday 8:30 A.M. to 5:00 P.M. and Friday 8:30 A.M. to 1:00 P.M. Digital files of the Contract Documents can be found on the State of Connecticut BizNet website at <https://biznet.ct.gov>

A satisfactory Bid Bond or Certified Check, the amount equal to ten percent (10%) of the base bid, shall be submitted with each bid. The Bid Bond or Certified Check shall be made payable to the City of Ansonia and shall be properly executed by the Bidder and acceptable sureties. All bonds must be sureties registered in the State of Connecticut.

Labor and Material Payment Bond and a Performance Bond for one hundred (100%) percent of the contract price, with a corporate surety approved by the City of Ansonia, will be required of the lowest responsible bidder.

The City of Ansonia hereby notifies all bidders that this contract has been assigned a **10% goal for DBE**, as certified by CTDOT. Bidders must indicate with their bid the DBE firm(s) they intend to utilize and submit the Pre-Award DBE Commitment Approval Request Forms with the bid forms.

The City reserves the right to reject any or all bids, in whole or in part, if it is deemed to be in the best interest of the City of Ansonia.

**The City of Ansonia is an Affirmative Action/Equal Opportunity Employer.
Minority/Women's Business Enterprises are encouraged to apply.**

Honorable David S. Cassetti

ITEM #0992132A – ORNAMENTAL MEDALLIONS

Description:

Work under this item shall consist of furnishing all equipment, tools, labor, and materials to perform all work necessary to install ornamental medallions at locations shown on the plans, as detailed or as directed by the Engineer.

Materials:

Flush bronze plaques shall be as manufactured by International Bronze.

Alternate vendor: Artistic Bronze, 8915 SW 19th Avenue Rd, Ocala, FL 34476 phone: (800) 330-7525 or as approved by the City.

The circular plaque shall be 30” in diameter and have the City of Ansonia seal, see attached details. The rectangular plaque shall be 36” by 36”, see attached detail for the text. Both plaques shall be shallow (1/8”) Bas-relief.

Chemical Anchors shall conform to Article M.03.07 of CTDOT Form 817.

Joint Materials shall conform to Article M.03.08 of CTDOT Form 817.

All steel components to be Buy America compliant.

Construction Methods:

Medallions shall be installed in the concrete sidewalk and concrete plazas at locations shown on the plans or as directed by the Engineer.

Prior to casting scale drawings shall be submitted for review and approval by the City of Ansonia.

Where ornamental medallions are to be set flush with concrete sidewalk, the sidewalk shall be formed to include a recess adequate to receive the medallion so that it is flush with the finished surface elevation.

Once the concrete sidewalk has cured the ornamental medallion shall be placed and secured using a chemical anchor suitable for use on bronze and concrete. The joint around the medallion perimeter shall be filled using self levelling joint material.

Method of Measurement:

This work will be measured for payment by the number of each “Ornamental Medallions” installed and accepted.

Basis of Payment:

The work shall be paid for at the contract unit price per each bid for “Ornamental Medallions”, completed and accepted in place, which price shall be complete and include all materials, equipment, tools, labor, and work incidental thereto.

Pay Item

Ornamental Medallions

Pay Unit

E.A.

City of Ansonia



Honorable David S. Cassetti, Mayor



The Ansonia Riverwalk is part of the Naugatuck River Greenway (NRG) which is an officially designated Connecticut State Greenway, consisting of Open and Green Spaces along the Naugatuck River.


This segment of the Ansonia Greenway is Section III and IV. This site in downtown Ansonia was severely impacted as part of the Ansonia Naugatuck River Valley flood of 1955.

Dedicated 2021

Designed by:
DeCarlo & Doll, Inc. / Tate & Associates, LLC.






TOWN SEAL PLAQUE SHALL BE 30" IN DIAMETER

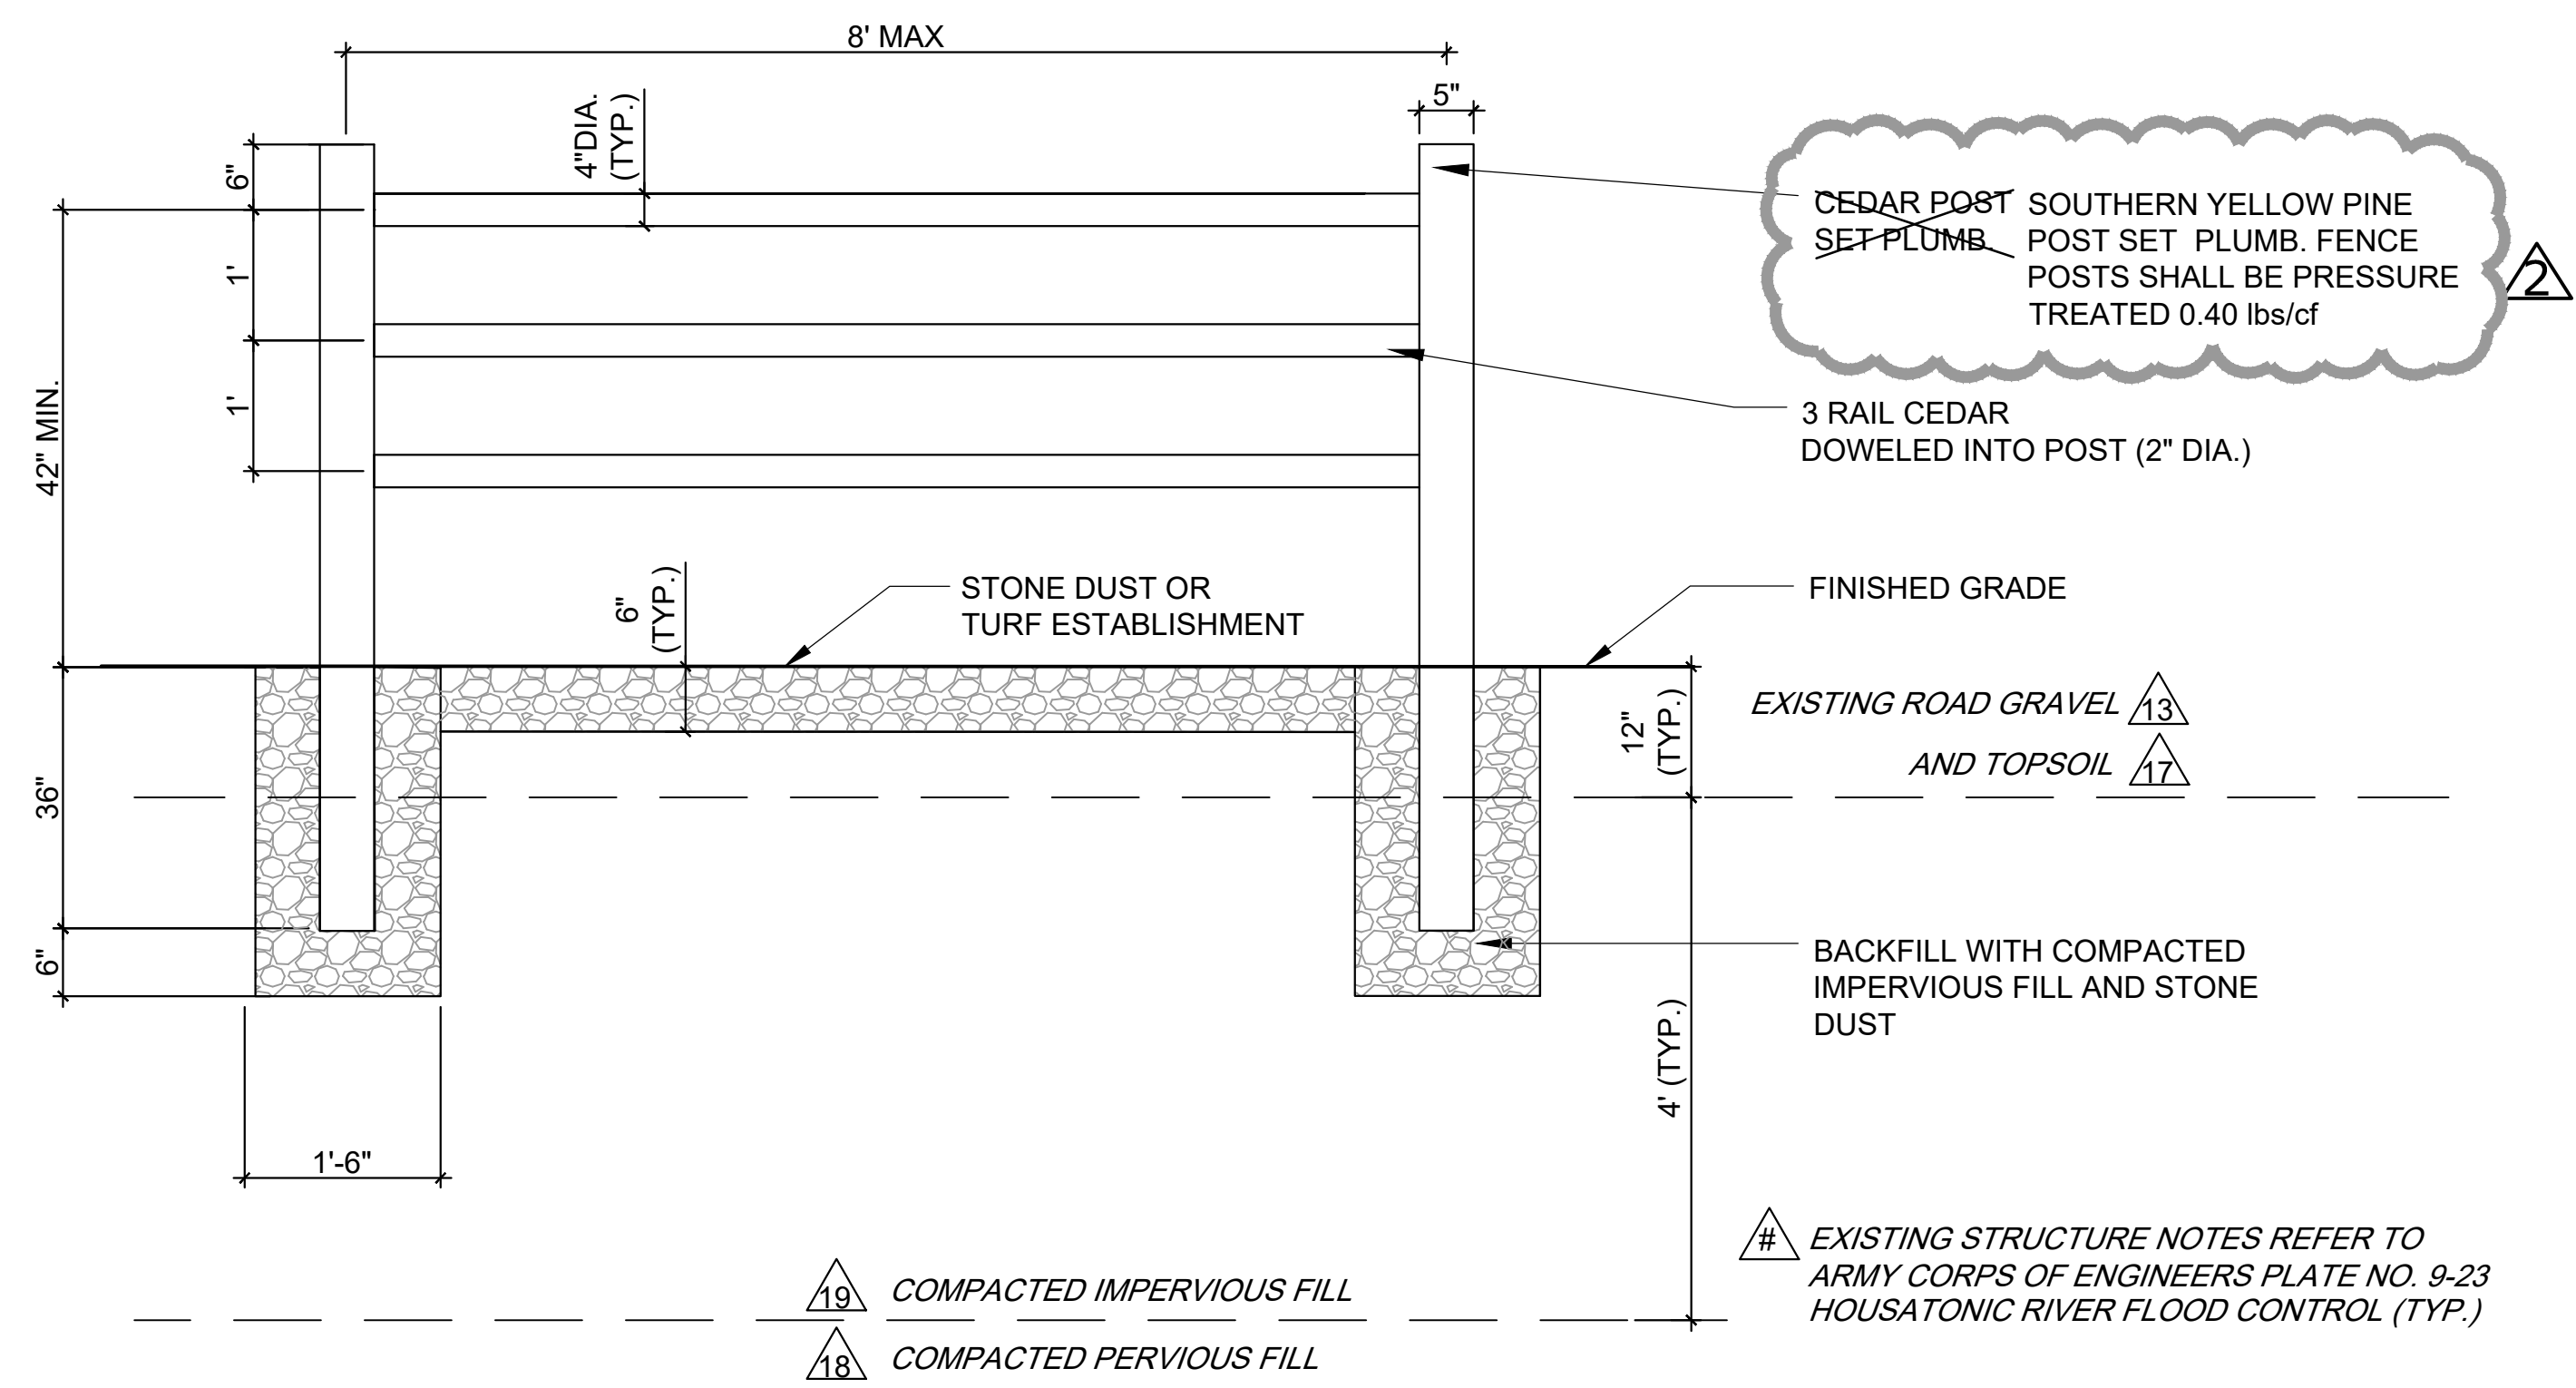


SPLIT RAIL FENCE SECTION

NTS

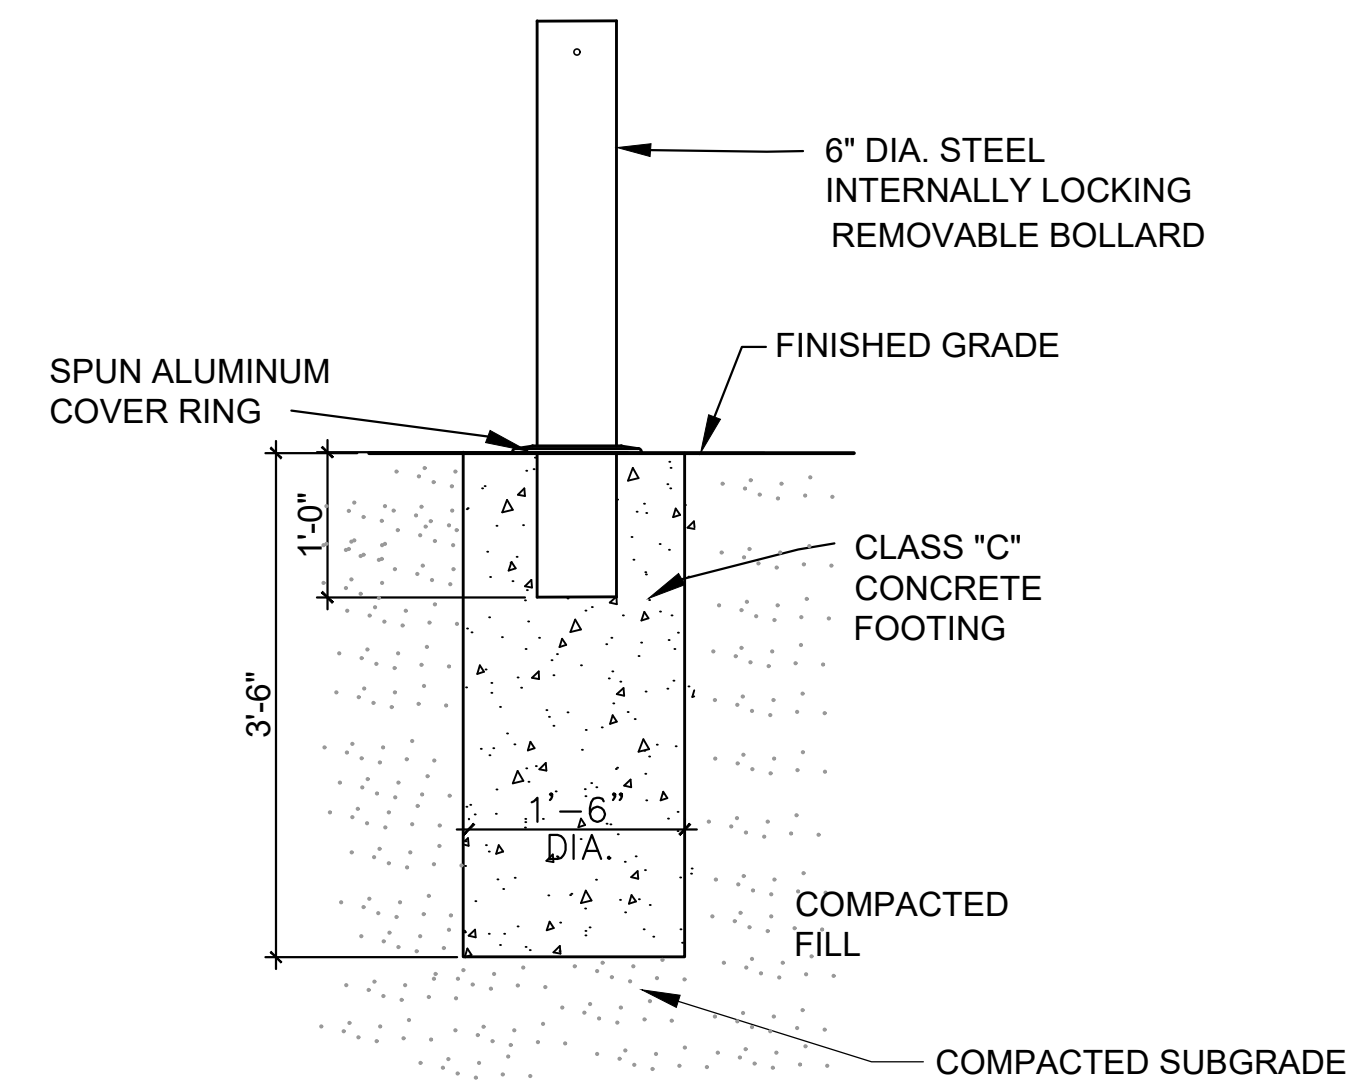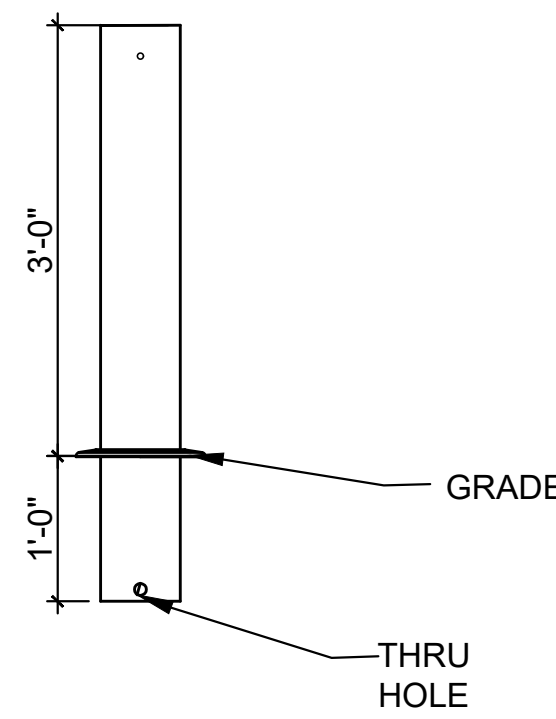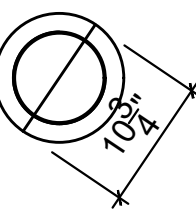

BOLLARD (REMOVABLE)


NTS

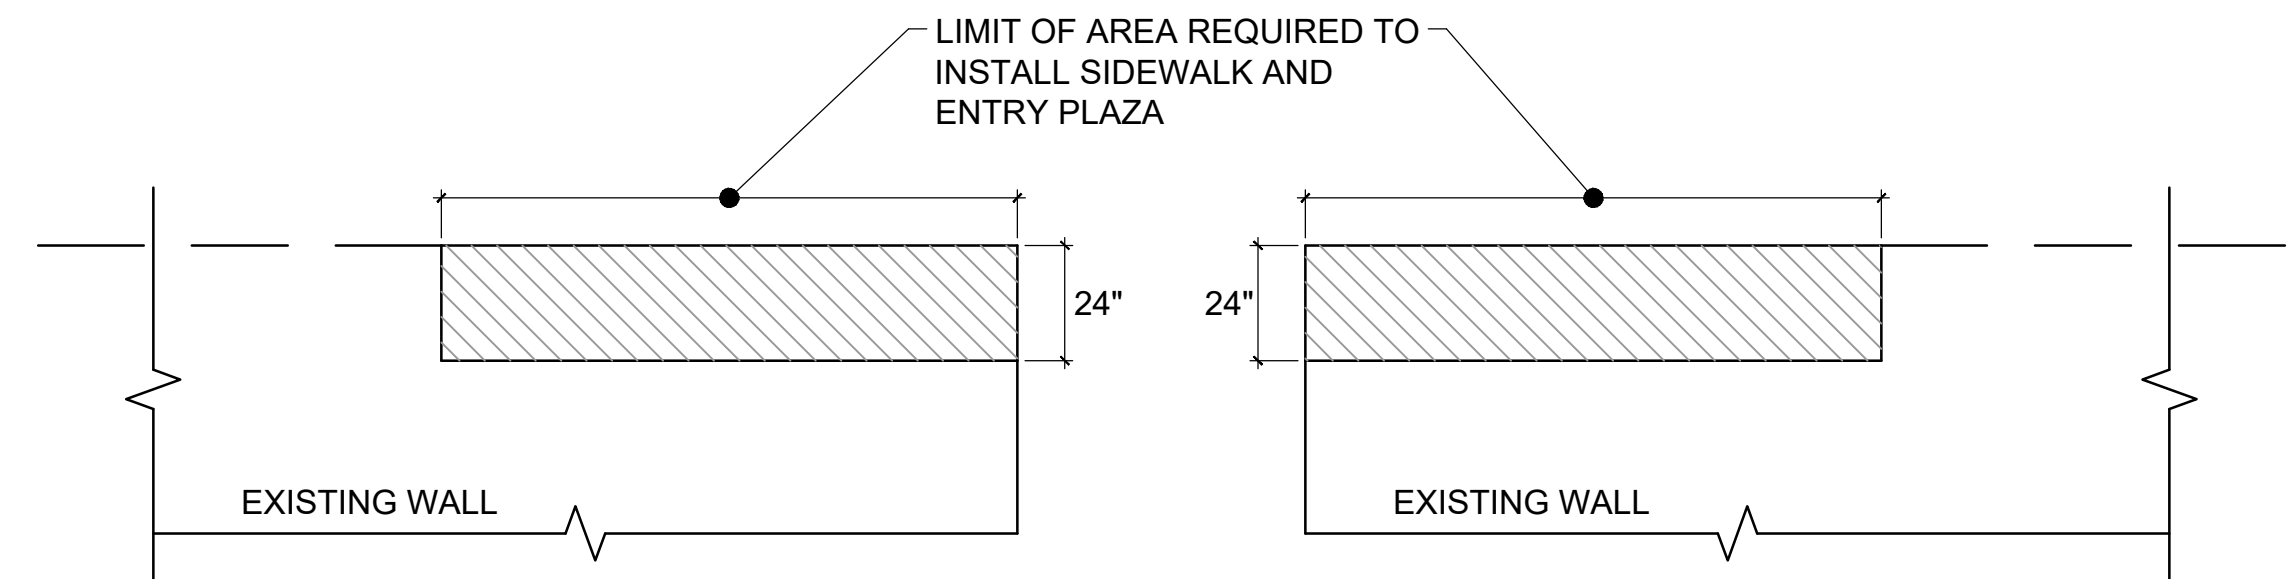

SOUTH ENTRANCE


EXISTING WALL MODIFICATION DETAIL

NTS

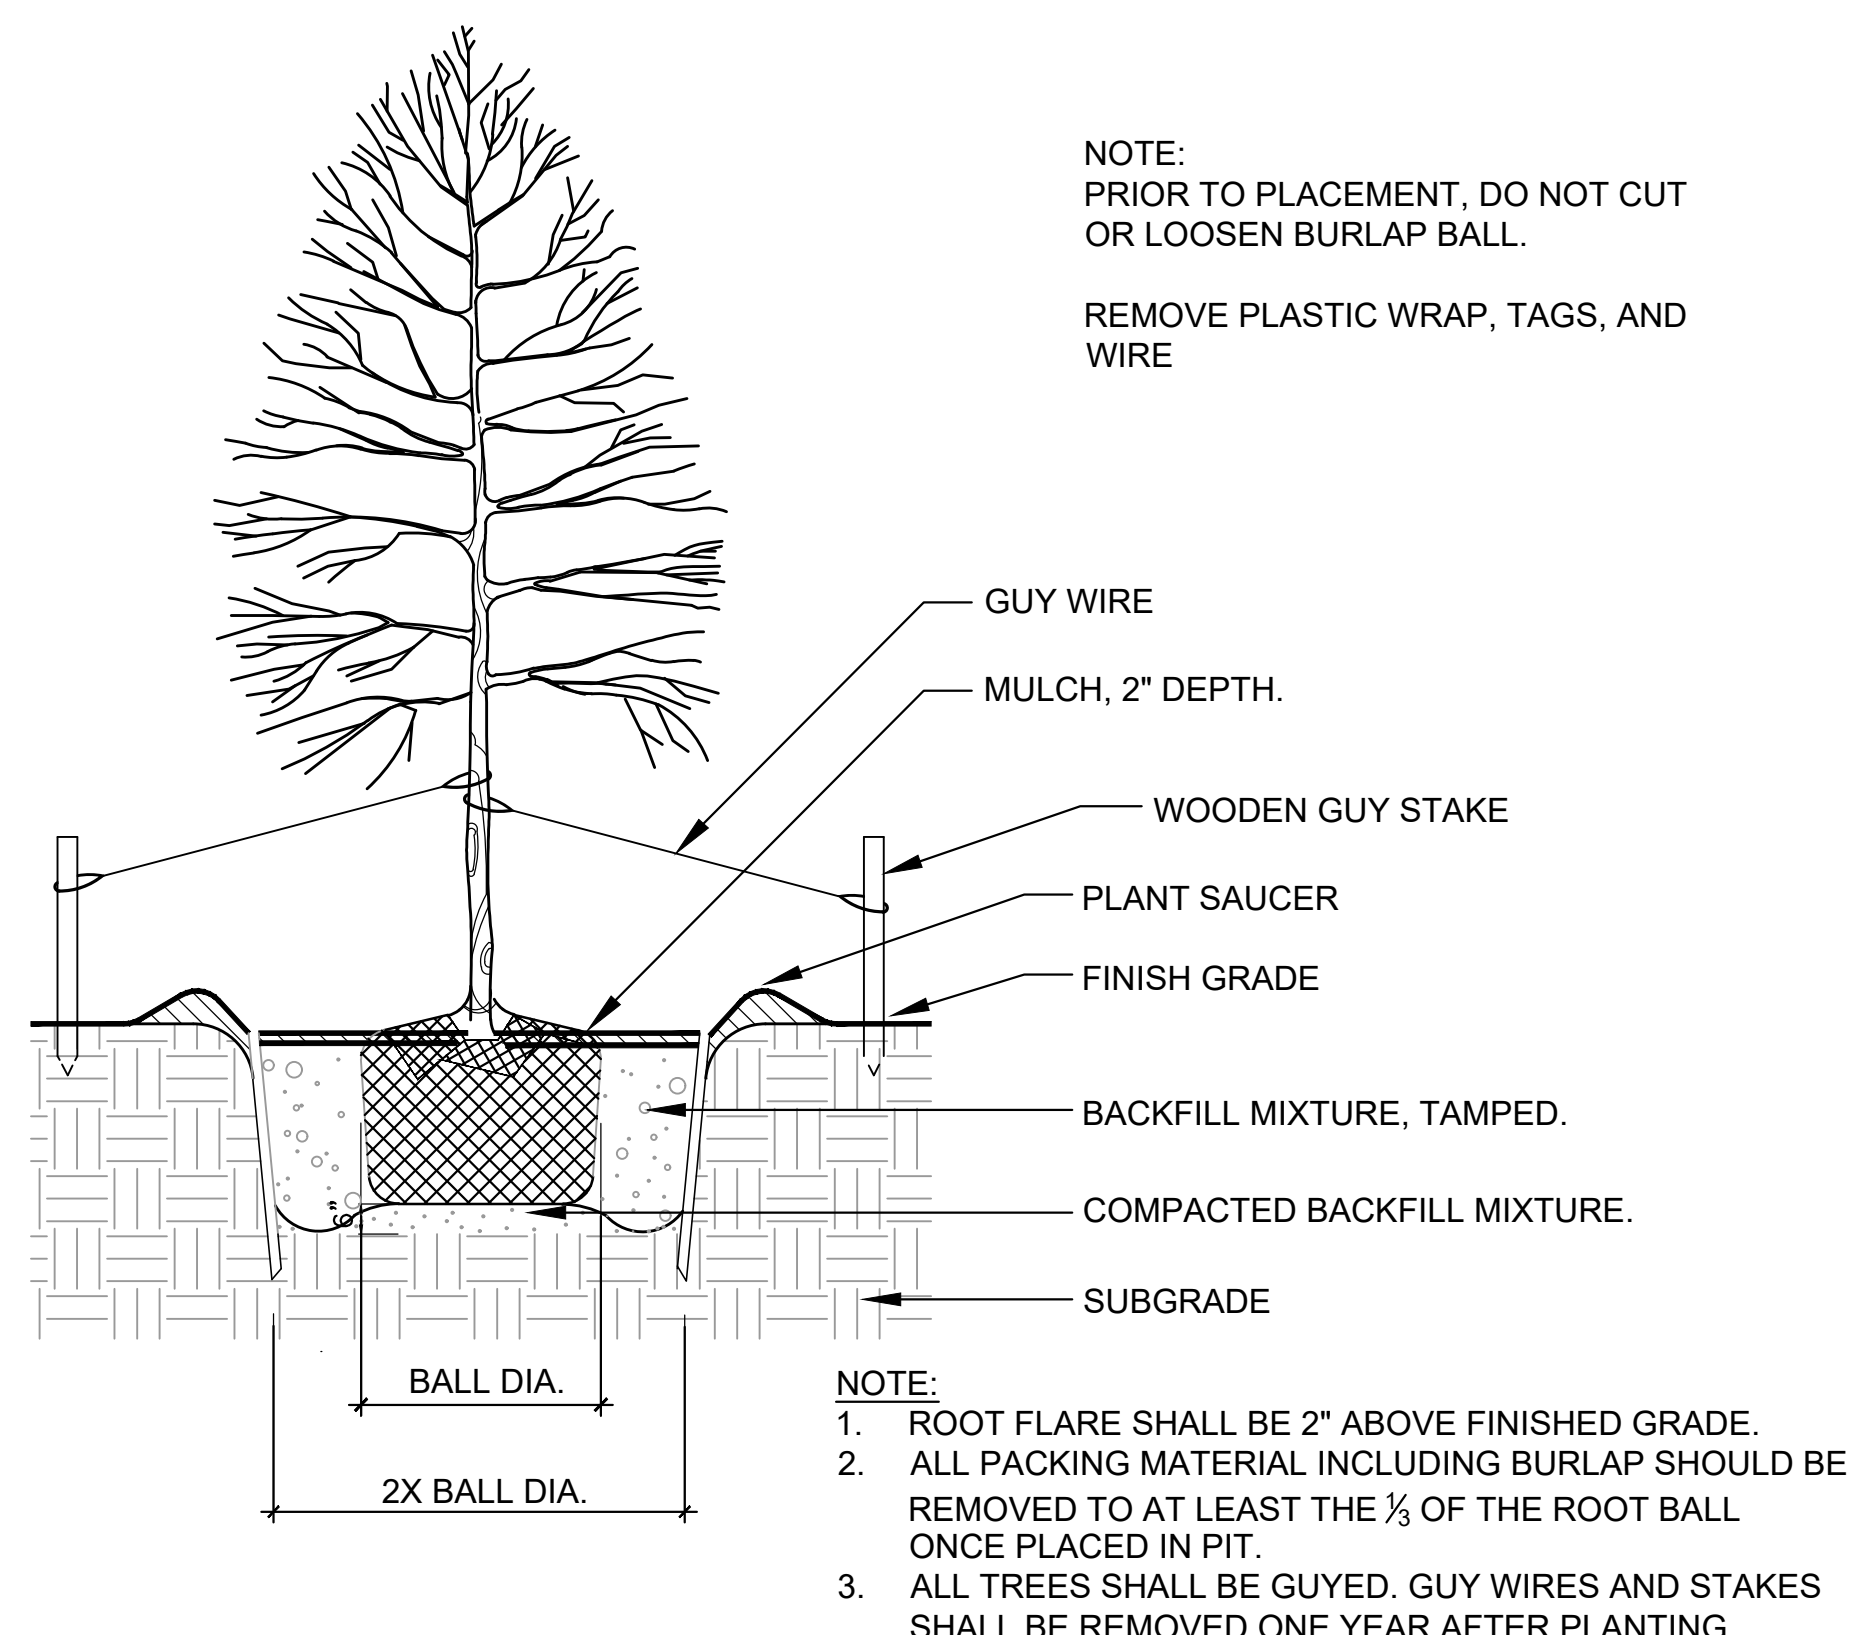


TYPICAL TREE PLANTING

NTS

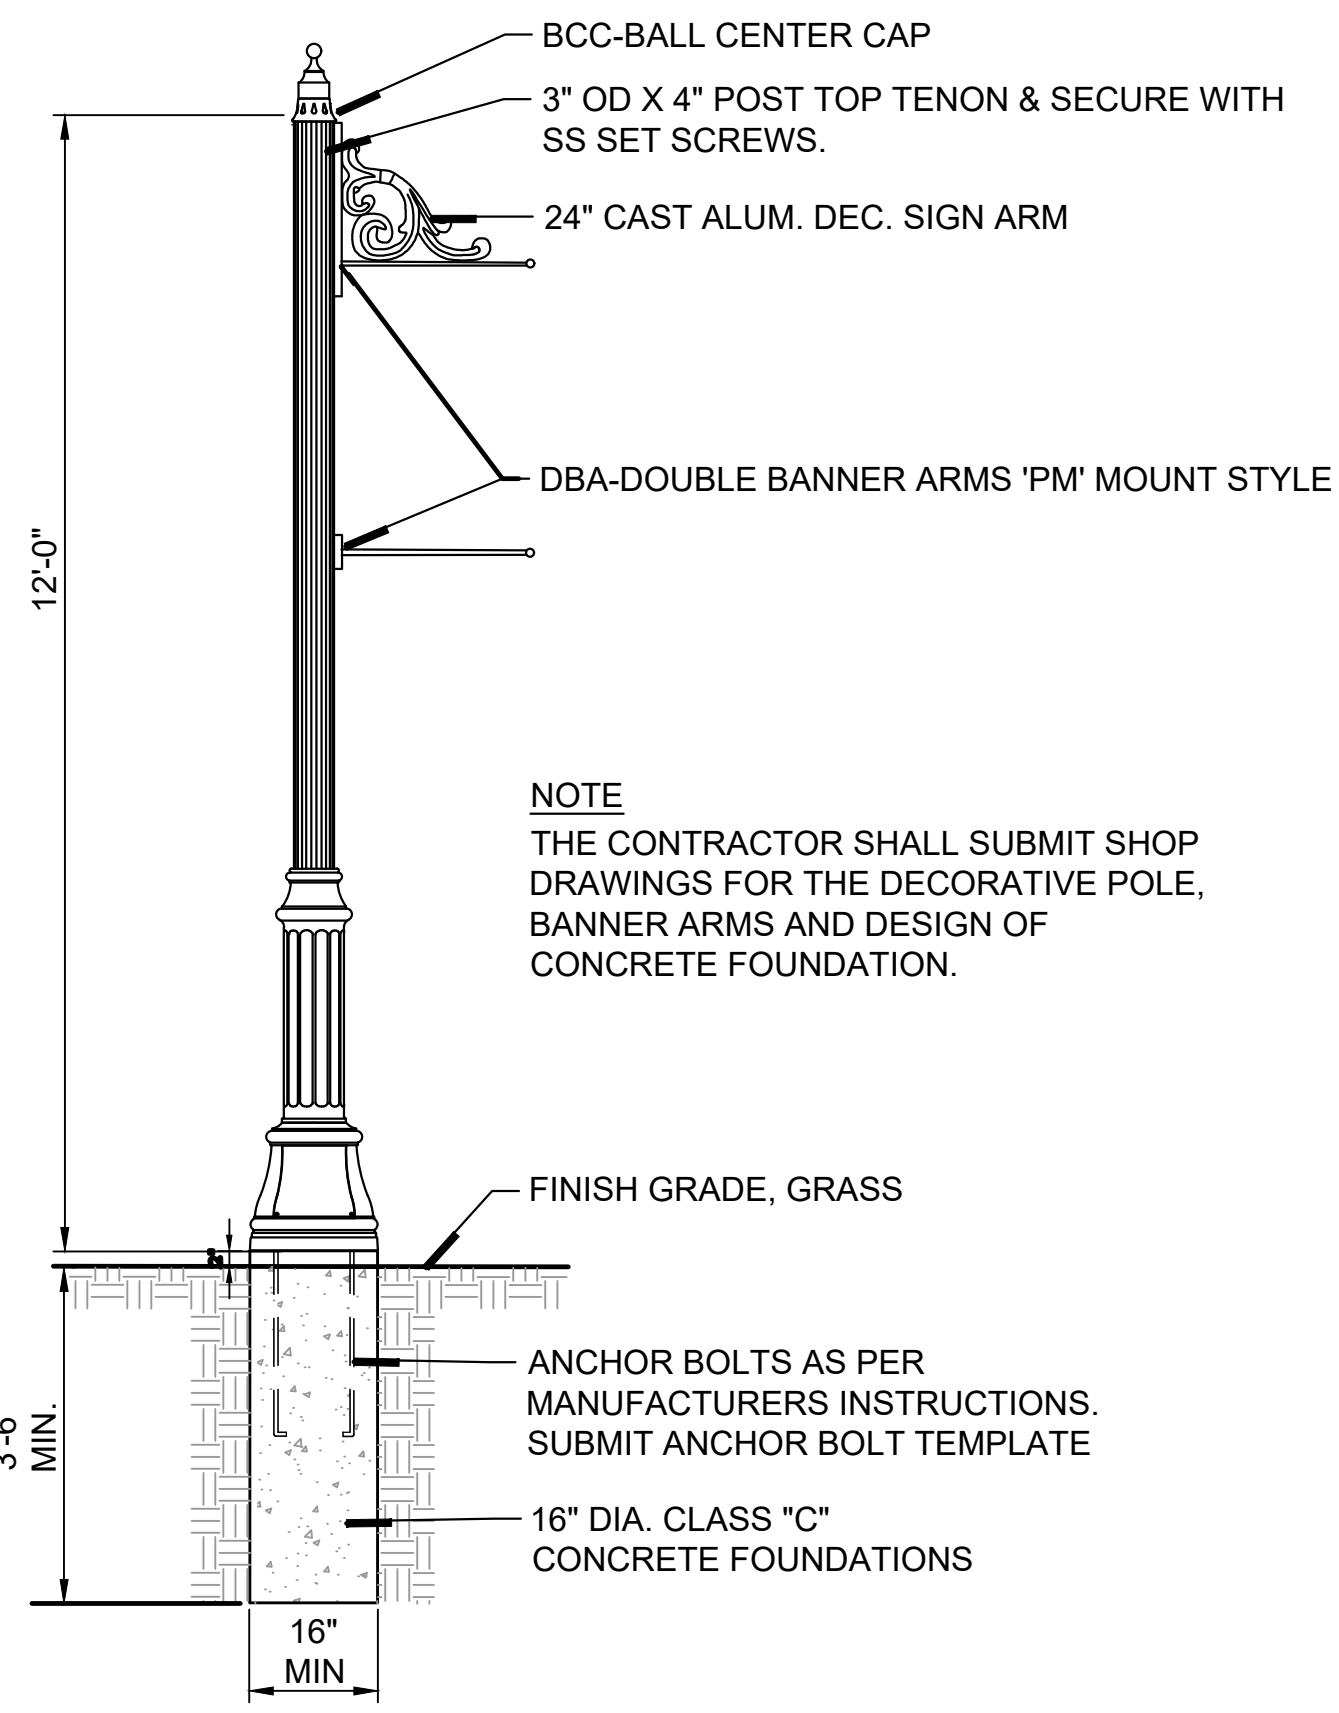

DECORATIVE POLE AND BANNER ARMS

NTS

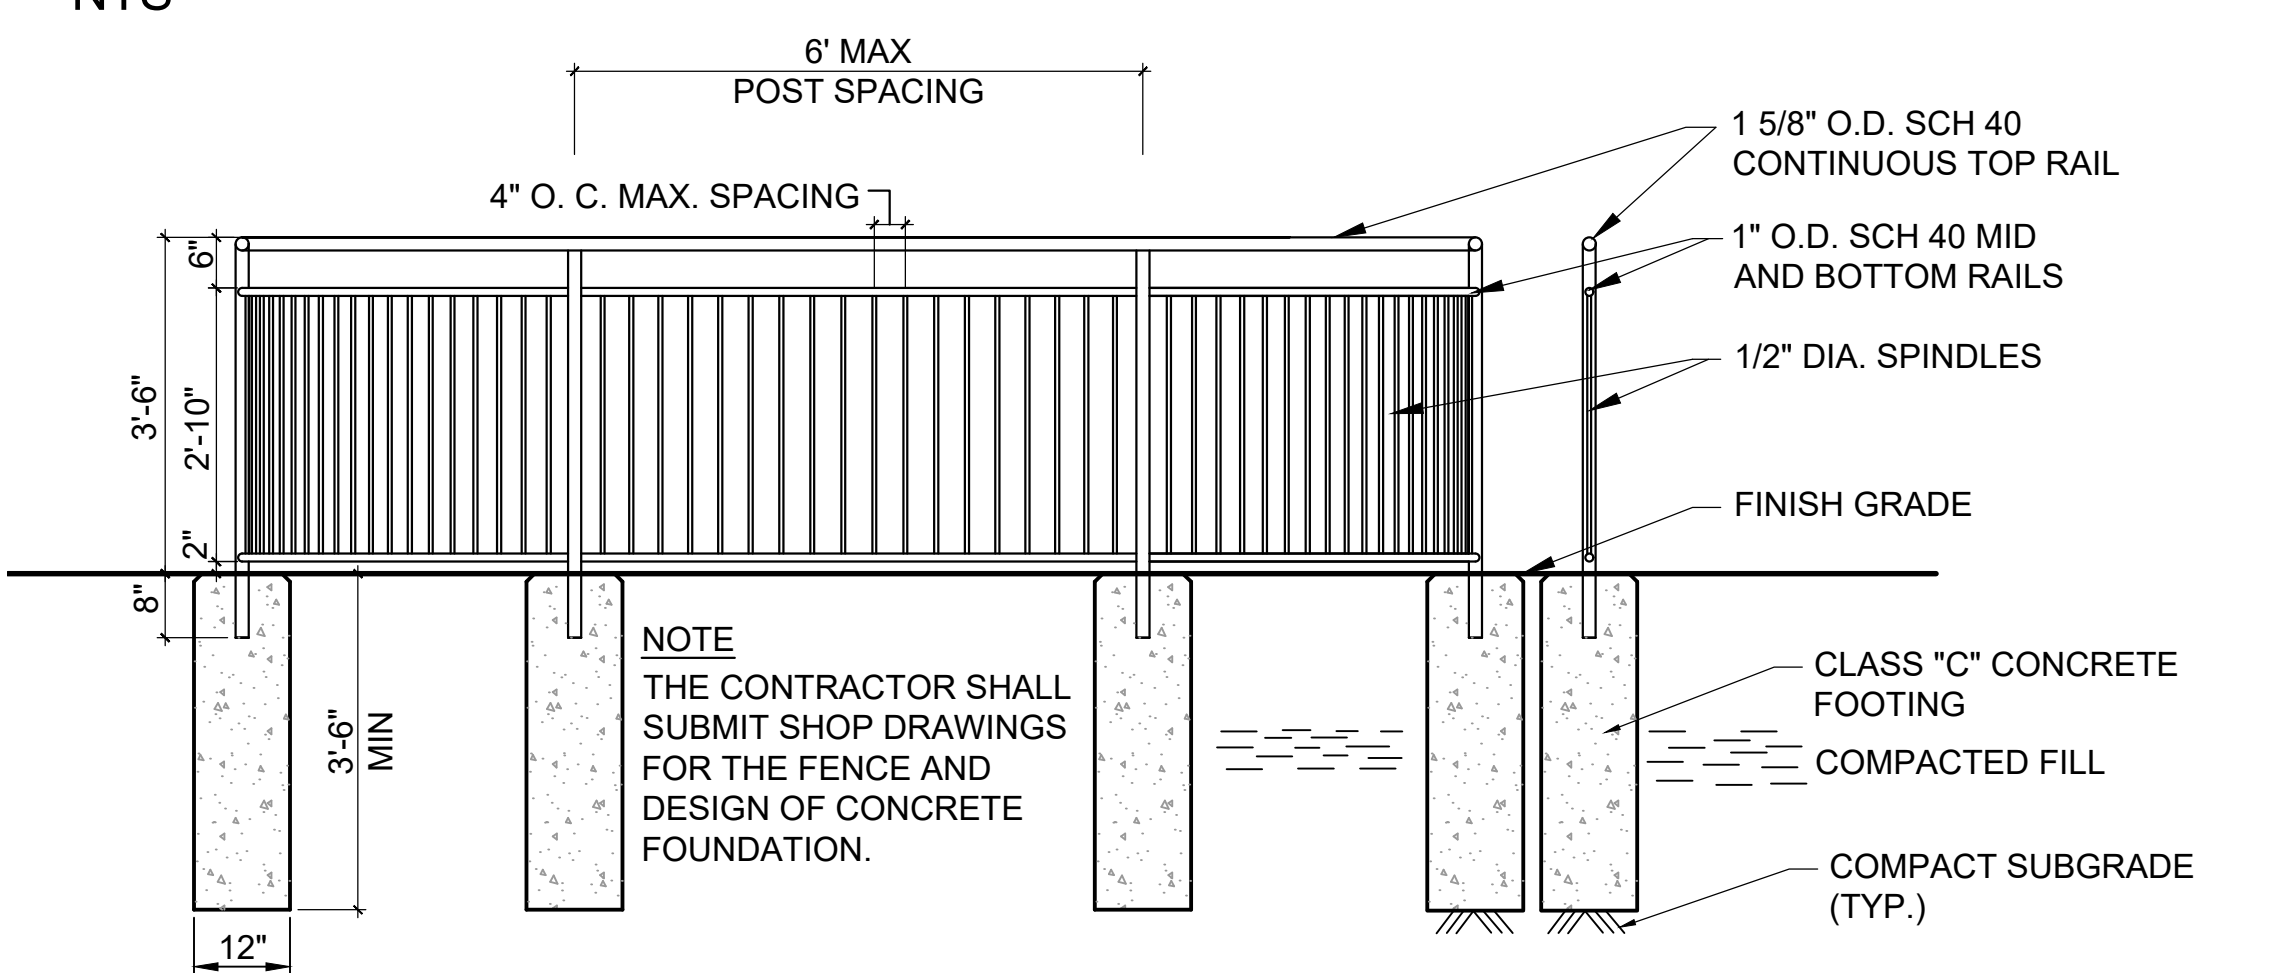

ORNAMENTAL METAL FENCE AT RIVER OVERLOOK

NTS

C:\Projects\DD Projects\51912 Ansonia Riverwalk_Sec 3 and 4\Bid Phase\Addendum 02\Drawings\002-128_Add 02_L-3 & L-4_Site Details.dwg

REV.	DATE	REVISION DESCRIPTION	SHEET NO.	DATE PLOTTED:
1	11/23/20	ADDENDUM NO.2	03.10.A2	11/23/2020
1	11/15/19	REVISED PER USACE COMMENTS		

DESIGNER/DRAFTER:
CHECKED BY:
SCALE AS NOTED

DeCarlo & Doll, Inc.
Professional Engineering & Land Surveying
89 Colony Street
Meriden, Connecticut 06451
(203) 379-0467
(203) 379-0276 fax

Tate & Associates, LLC
Landscape Architecture
Environmental Site Planning
Urban Design
10 Saco Hill Road
Fairfield, Connecticut 06824
(203) 255-9011
(203) 255-9022 fax

SIGNATURE/BLOCK:

PROJECT TITLE:
CONSTRUCTION OF ANSONIA RIVERWALK - SEGMENTS 3 & 4 PREPARED FOR THE CITY OF ANSONIA


TOWN:
ANSONIA

DRAWING TITLE:
SITE DETAILS

PROJECT NO.:
02-128

DRAWING NO.:
L-3


SHEET NO.:

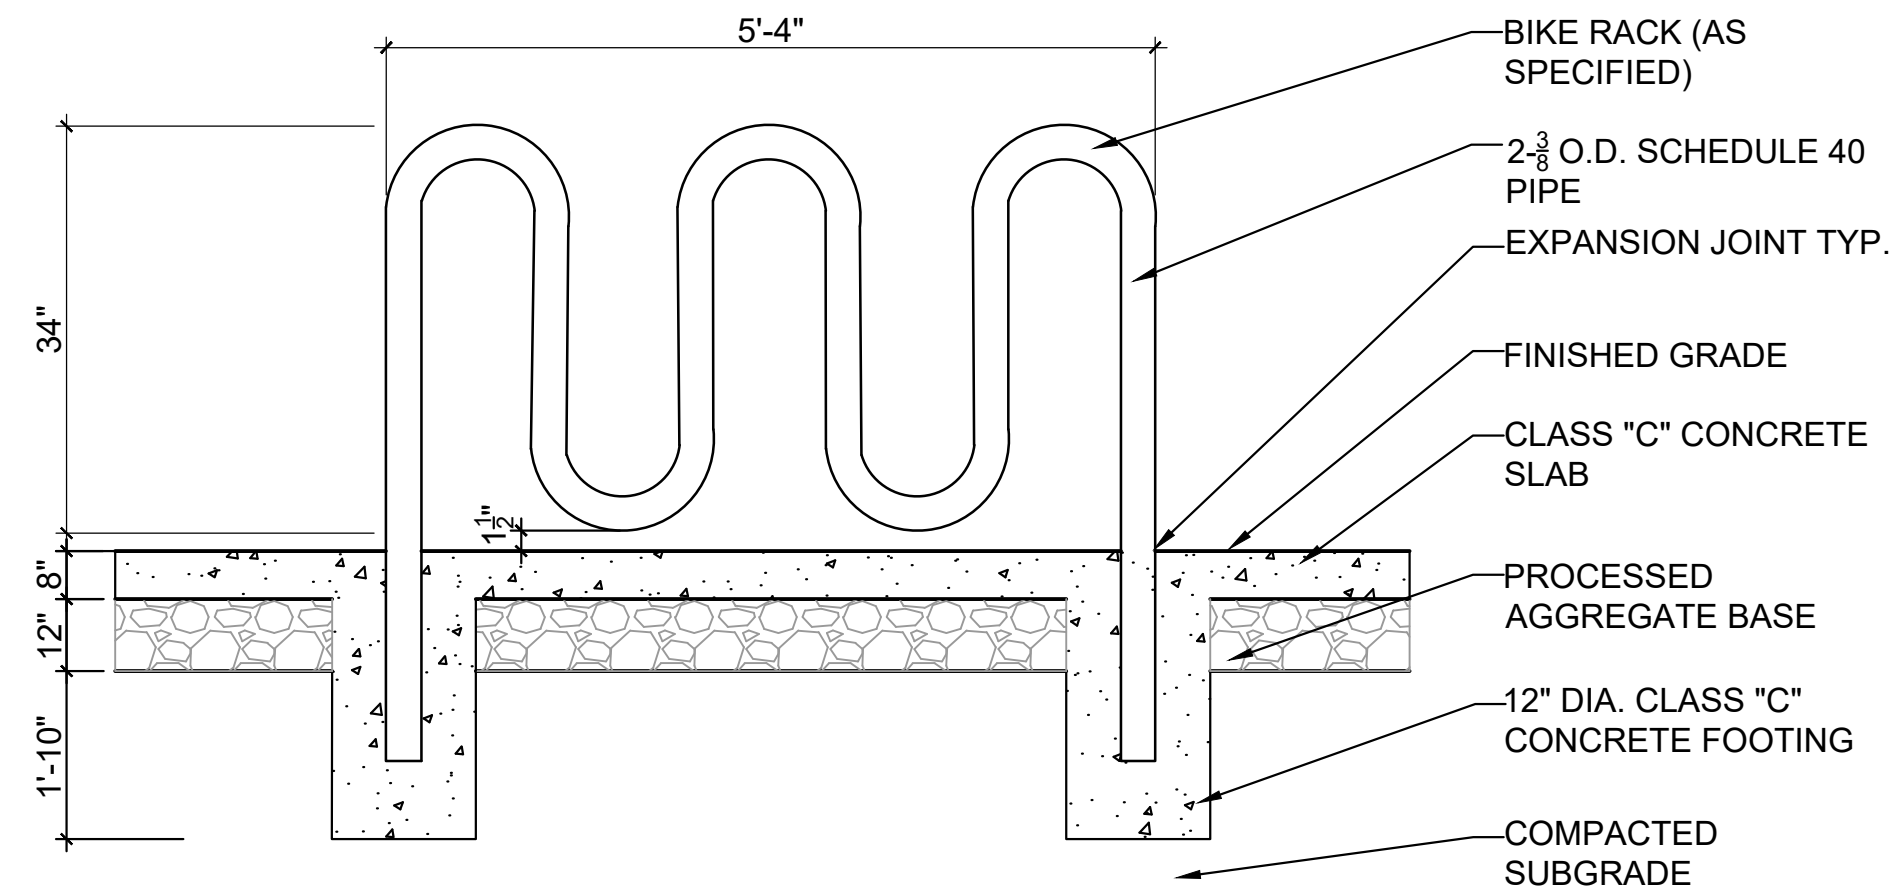

NOTE:
BIKE RACK TO BE PAID FOR UNDER
THE ITEM "BICYCLE STAND"

BIKE RACK DETAIL

NTS

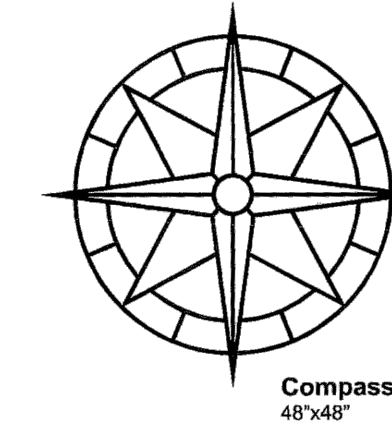


Compass Rose Narrow, CD-1001
48"x48"

NOTE:
THE COMPASS ROSE SHALL BE STAMPED CONCRETE,
IT SHALL BE STAINED IN AN ANTIQUED STYLE. THE
COMPASS ROSE WILL BE PAID FOR AS A LUMP
SUM UNDER ITEM #0601401A ORNAMENT MOLDS


48"x48" COMPASS ROSE NARROW DETAIL

NTS

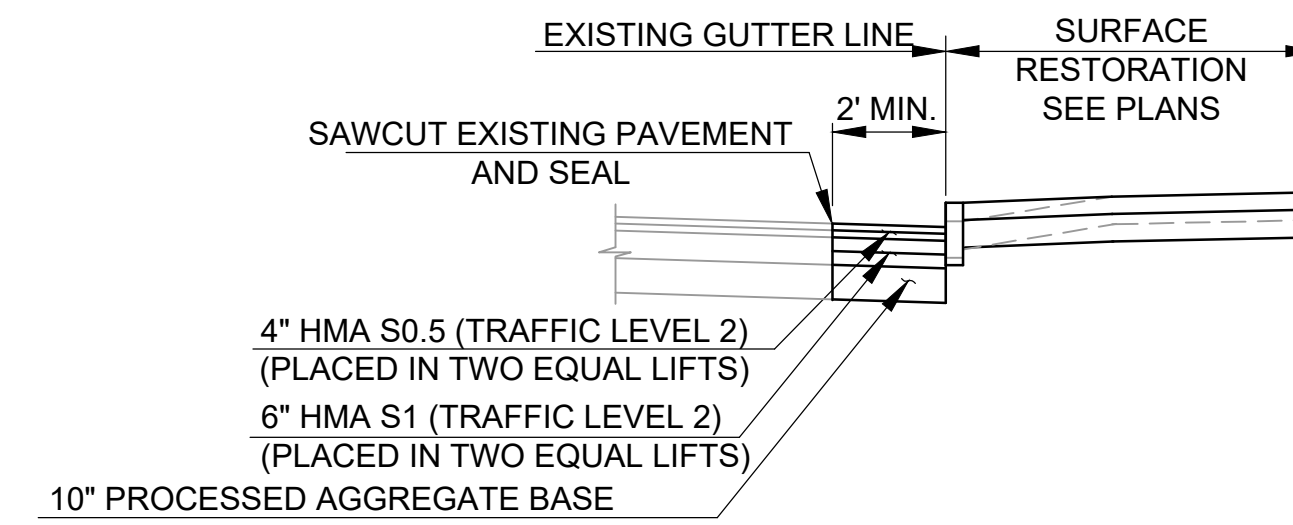


PAVEMENT RESTORATION DETAIL

NTS

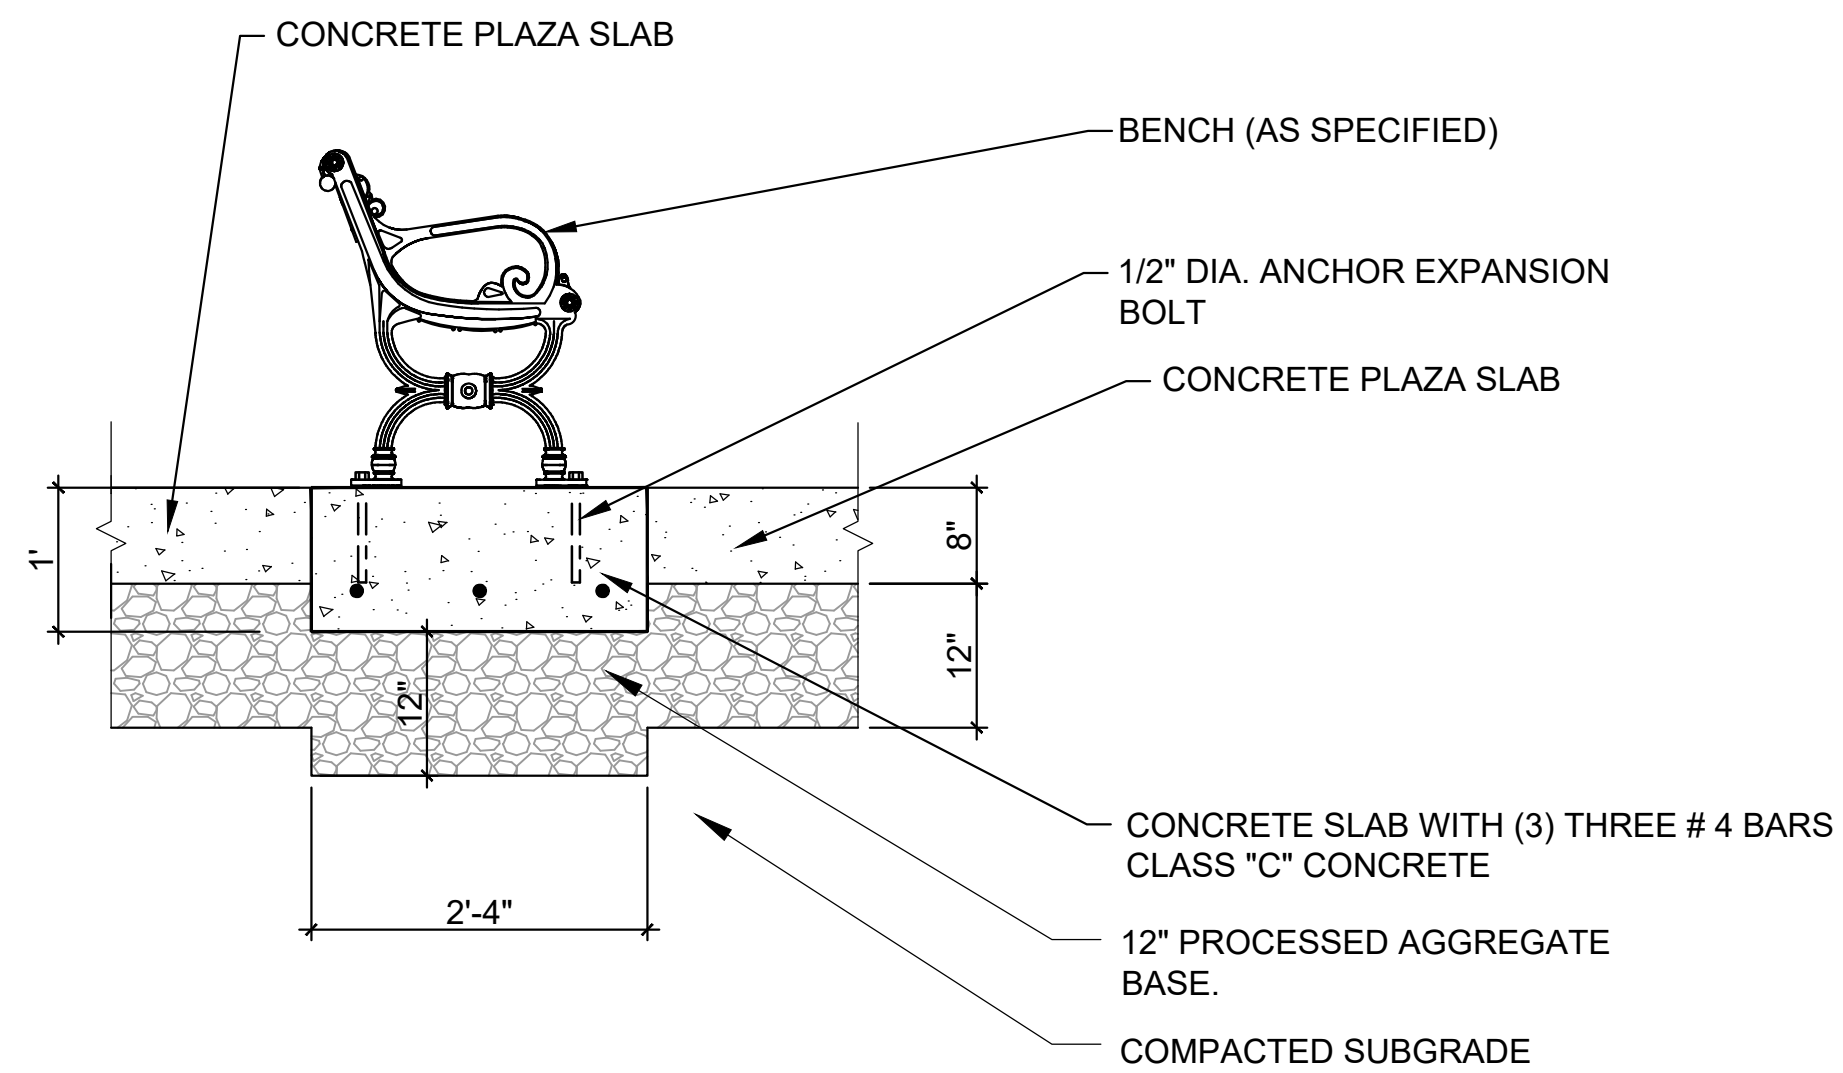

BENCH DETAIL

NTS

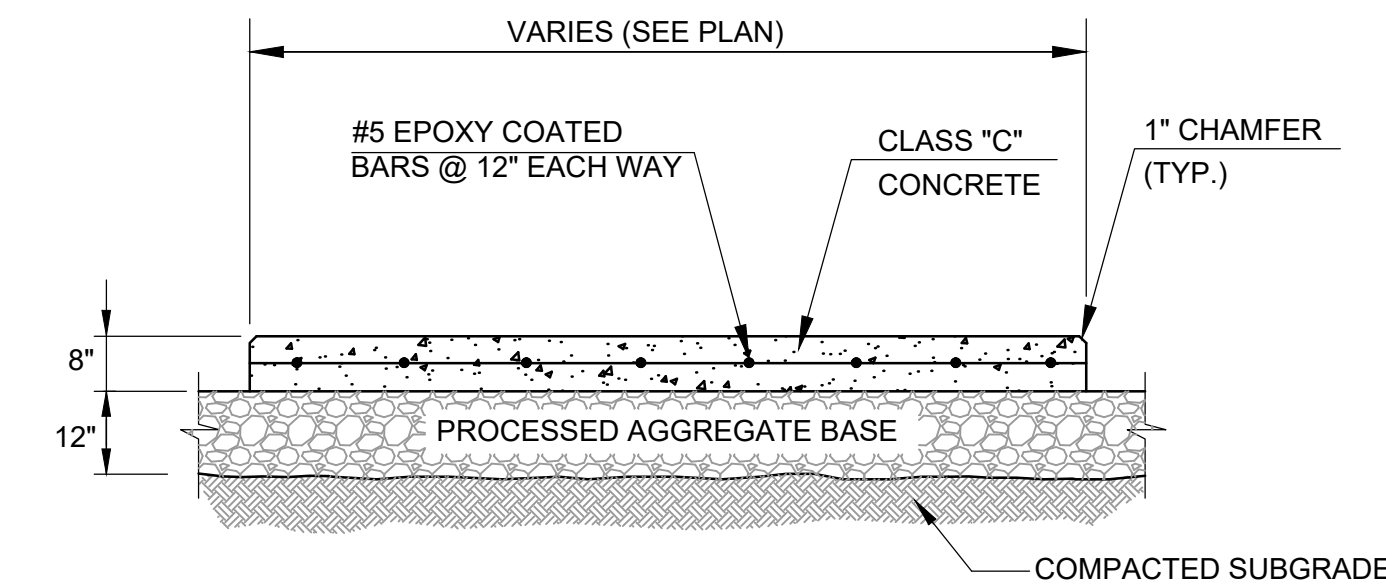

NOTE: DOWEL CONCRETE SIDEWALK INTO ADJACENT
EXISTING SIDEWALK

**CONCRETE PLAZA, REST SHELTER
OVERLOOK SLAB DETAIL**

NTS

C:\Projects\DD Projects\515112 Ansonia Riverwalk_Sec 3 and 4\Bid Phase\Addendum 02\Drawings\002-128_Add 02_L-3 & L-4_Site details.dwg

REV.	DATE	REVISION DESCRIPTION	SHEET NO.	DATE PLOTTED:
11/23/20	ADDENDUM NO.2		03.11.A2	11/23/2020

THE INFORMATION, INCLUDING ESTIMATED QUANTITIES OF WORK, SHOWN ON THESE SHEETS IS BASED ON LIMITED INVESTIGATIONS BY THE STATE AND IS IN NO WAY WARRANTED TO INDICATE THE CONDITIONS OF ACTUAL QUANTITIES OF WORK WHICH WILL BE REQUIRED.

DESIGNER/DRAFTER:
CHECKED BY:
SCALE AS NOTED

DeCarlo & Doll, Inc.
Professional Engineering
& Land Surveying
89 Colony Street
Meriden, Connecticut 06451
(203) 379-0467
(203) 379-0278 fax

Tate & Associates, LLC
Landscape Architecture
Environmental Site Planning
Urban Design
10 Saco Hill Road
Fairfield, Connecticut 06824
(203) 255-9011
(205) 255-9022 fax

SIGNATURE/
BLOCK:

PROJECT TITLE:
**CONSTRUCTION OF
ANSONIA RIVERWALK - SEGMENTS 3 & 4
PREPARED FOR THE CITY OF ANSONIA**

TOWN:
ANSONIA

DRAWING TITLE:
SITE DETAILS

PROJECT NO.:
02-128

DRAWING NO.:
L-4

SHEET NO.: